
SPRINGFIELD ESTATES COMMUNITY SEPTIC DRAIFIELD

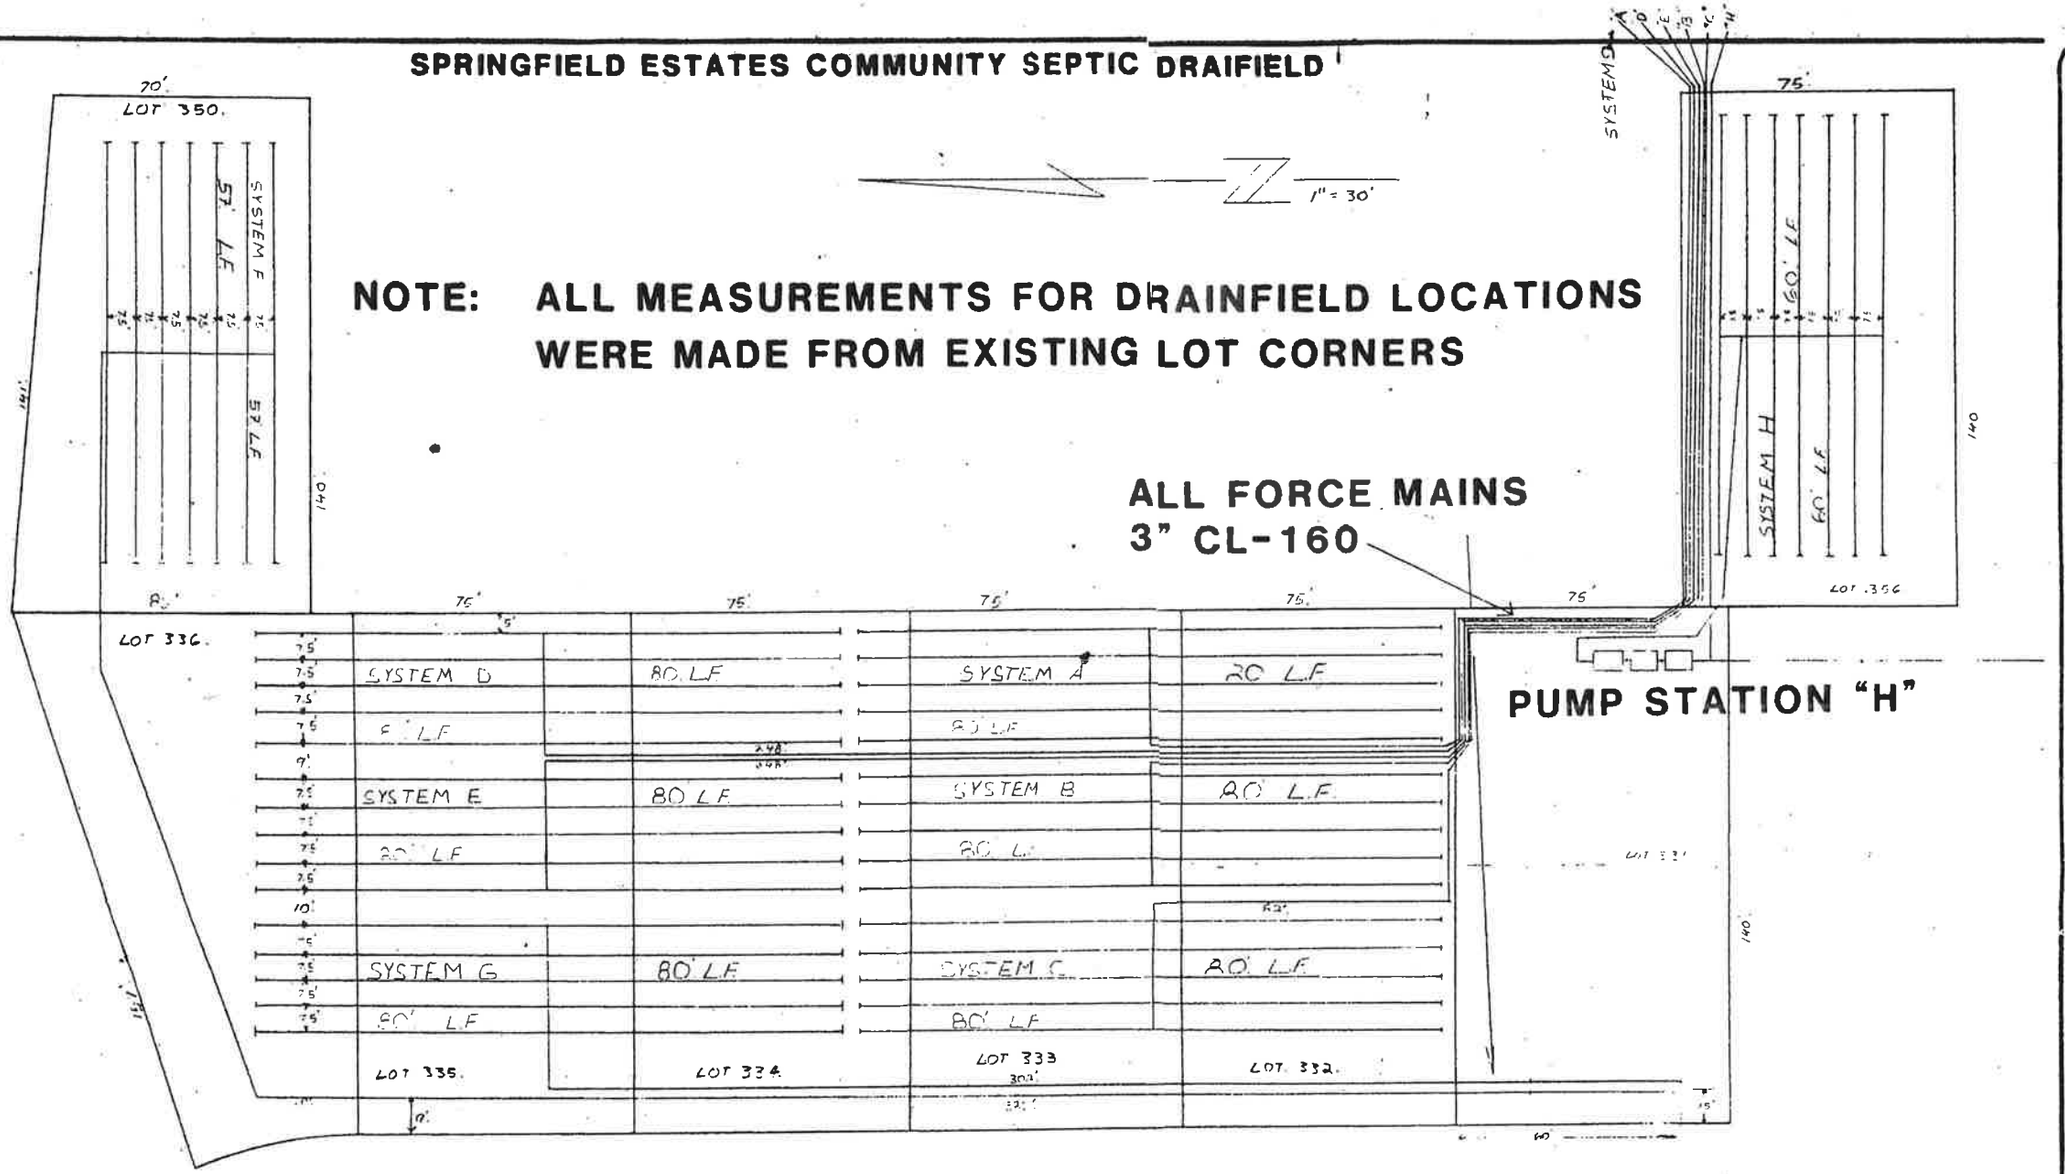

1" = 30'

NOTE: ALL MEASUREMENTS FOR DRAINFIELD LOCATIONS WERE MADE FROM EXISTING LOT CORNERS

ALL FORCE MAINS 3" CL-160

A-11

DESIGN
DRAWN CW
CHECKED
SEC 21/26 T 19 N R 4E
FIELD BK — DATE 7/20/87
SCALE 1" = 30'


REV NO	REVISION DESCRIPTION	DATE	BY

TITLE SPRINGFIELD AS-BUILT

CLIENT HELLER FINANCIAL
600 108th AVE NE, SUITE 1040
BELLEVUE, WA. 98004

173-4491
(206) 277-2833
ION 681-2833

A-H Reserves

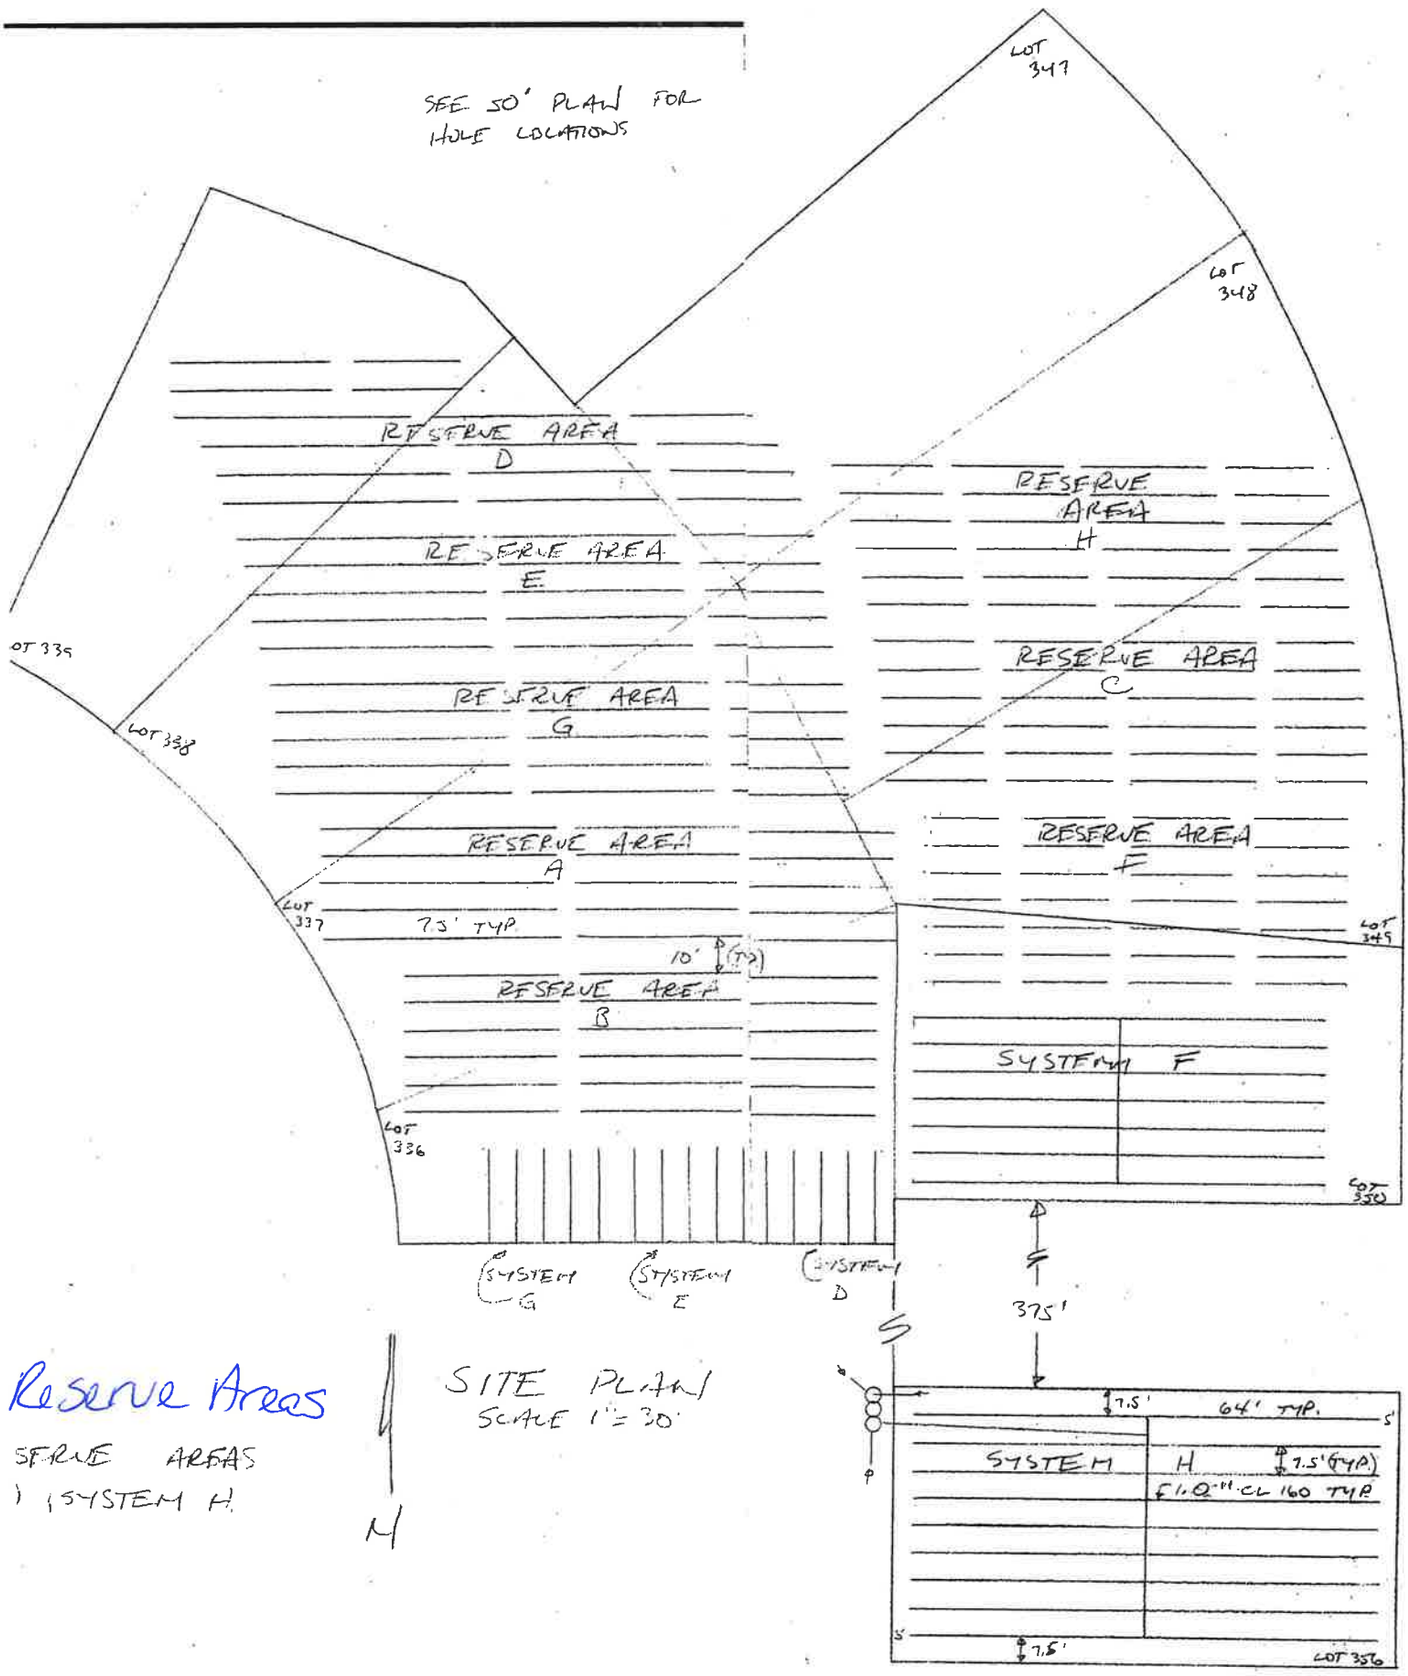

Reserve Areas

SERVE AREAS
) SYSTEM H

SITE PLAN
SCALE 1" = 30'

① 0-67 Lo. Sa.
>67 H_2O

② 0-18 T S.
18-31 Lo. Sa
31-64 Med. Sa.

③ 0-60 Lo. Sa.
>60 H_2O

④ 0-20 T S,
20-68 Lo. Sa.
>68 H_2O
H_2O 56


⑤ 0.21 Lo. Sa.
21-55 Mo. Sa. H_2O 46
>55 H_2O

⑥ 0-23 Lo Sa.
23-52 Mo. Sa. H_2O 44 RING 34
>52 H_2O


⑦ 0-28 Lo Sa.
28-50 Mo. Sa. H_2O 36 RING 32
>50 H_2O

⑧ 0.50 Lo. Sa.
>50 H_2O. H_2O 36 R 30

PROVIDE

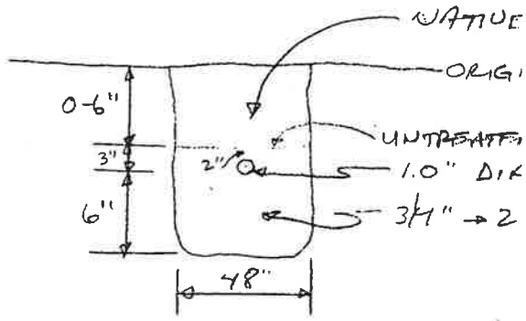

TRENCH DETAIL
N/TS

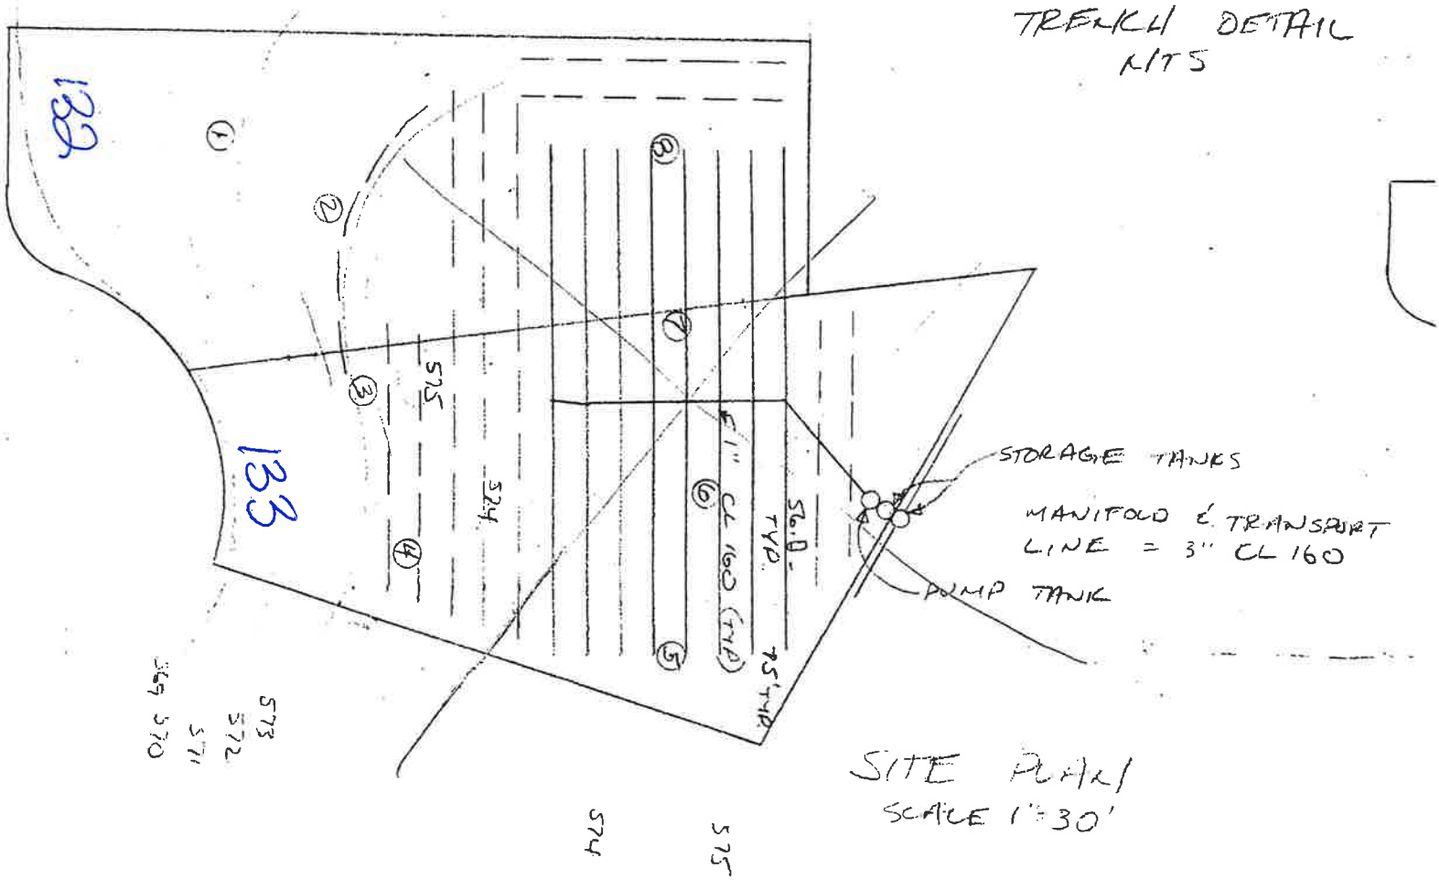

SITE PLAN
SCALE 1"=30'





DESIGNED BY: GR
33
TM

DESIGNED FOR: T
P
P

System I

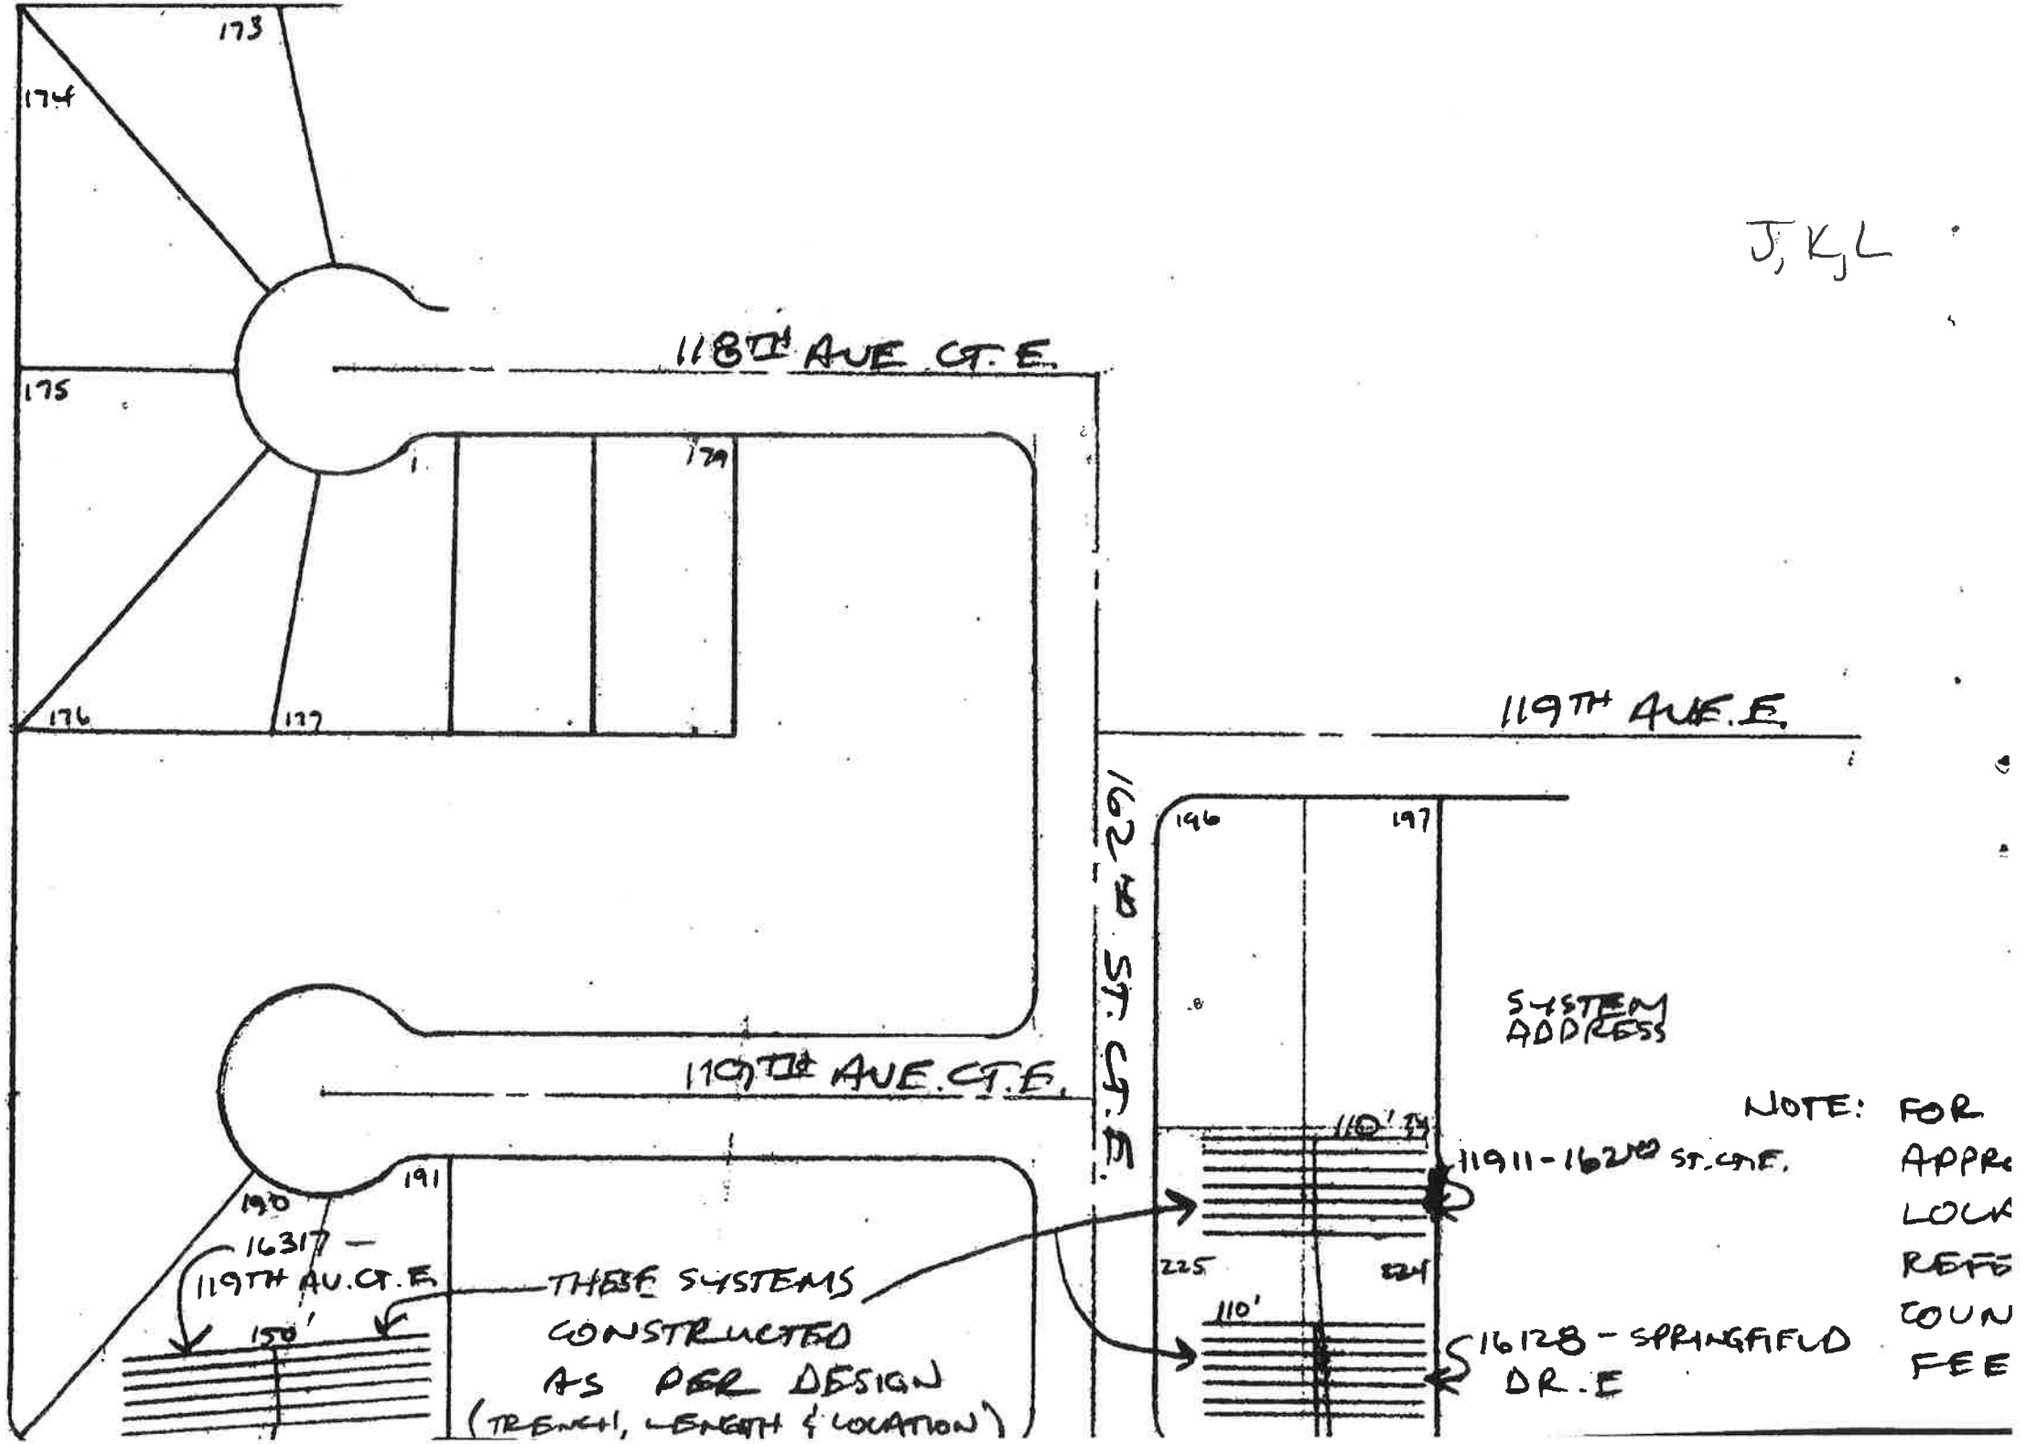
J, K, L
173
174
175
176
177
178
118TH AVE CT. E.
119TH AVE. E.
162ND ST. CT. E.
196
197
SYSTEM ADDRESS
110'
11911 - 162ND ST. CT. E.
225
224
110'
16128 - SPRINGFIELD DR. E
NOTE: FOR APPR LOCA REFE COUN FEE
190
191
16317 - 119TH AV. CT. E.
150'
THESE SYSTEMS CONSTRUCTED AS PER DESIGN (TRENCH, LENGTH & LOCATION)
119TH AVE. CT. E.

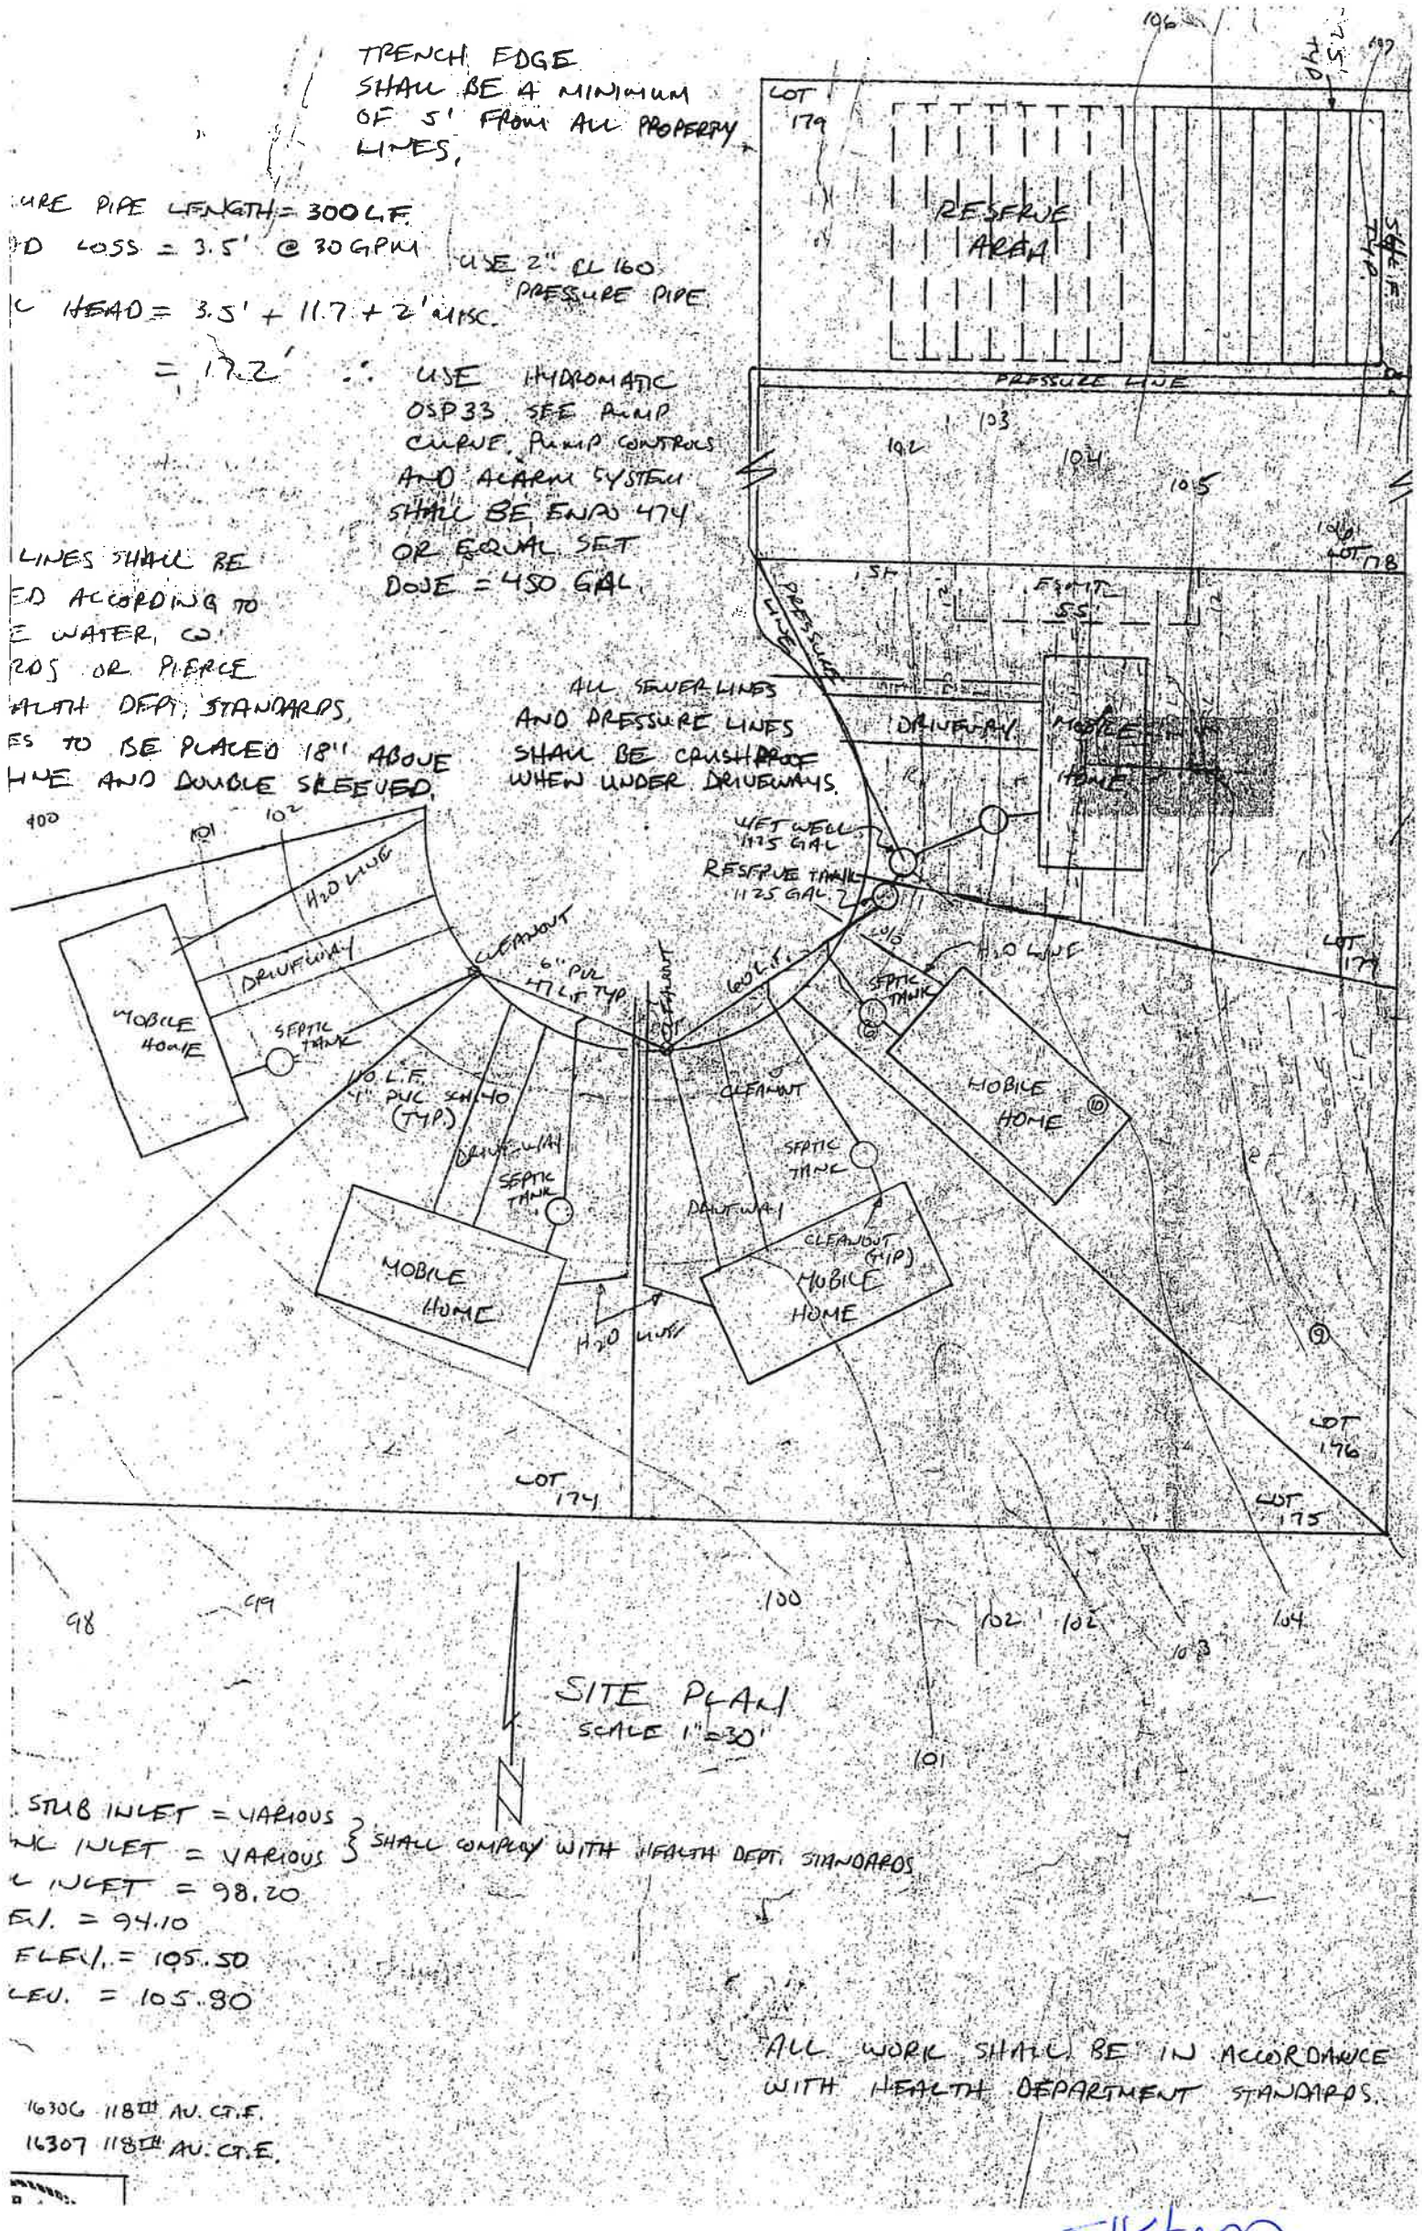
TRENCH EDGE SHALL BE A MINIMUM OF 5' FROM ALL PROPERTY LINES.
URE PIPE LENGTH = 300 L.F.
D LOSS = 3.5' @ 30 GPM
USE 2" CL 160 PRESSURE PIPE
C HEAD = 3.5' + 11.7 + 2' MISC.
= 17.2' ∴ USE HYDROMATIC OSP33 SEE PUMP CURVE. PUMP CONTROLS AND ALARM SYSTEM SHALL BE ENP 474 OR EQUAL SET DOSE = 450 GAL.
LINES SHALL BE ED ACCORDING TO E WATER CO. R205 OR PIERCE ALTH DEPT. STANDARDS. ES TO BE PLACED 18" ABOVE HUE AND DOUBLE SLEEVED.
ALL SEWER LINES AND PRESSURE LINES SHALL BE CRUSHPROOF WHEN UNDER DRIVEWAYS.
LOT 179
RESERVE AREA
PRESSURE LINE
LOT 178
DRIVEWAY
MOBILE HOME
WET WELL 1175 GAL
RESERVE TANK 1125 GAL
H2O LINE
SEPTIC TANK
CLEANOUT
6" PVC @ 1% L.F. TYP
100 L.F.
4" PVC SCH 40 (TYP.)
LOT 174
LOT 176
LOT 175
SITE PLAN
SCALE 1"=30'
STUB INLET = VARIOUS
INC INLET = VARIOUS
INLET = 98.20
EL. = 94.10
ELEV. = 105.50
ELEV. = 105.80
SHALL COMPLY WITH HEALTH DEPT. STANDARDS
ALL WORK SHALL BE IN ACCORDANCE WITH HEALTH DEPARTMENT STANDARDS.
16306 118TH AV. CT. E.
16307 118TH AV. CT. E.

System
M